


1
SK-2 **BASEMENT FLOOR PLAN**

1/8" = 1'-0"
0' 8'-0" 16'-0"

NOTES:

1. Drawing based on field measurements made by a representative of Day Engineering, P.C. during October 2022. Drawing is not guaranteed to be accurate, and should be considered accurate to the degree implied by the method used. Dimensions shown are from record drawings and were not field confirmed.

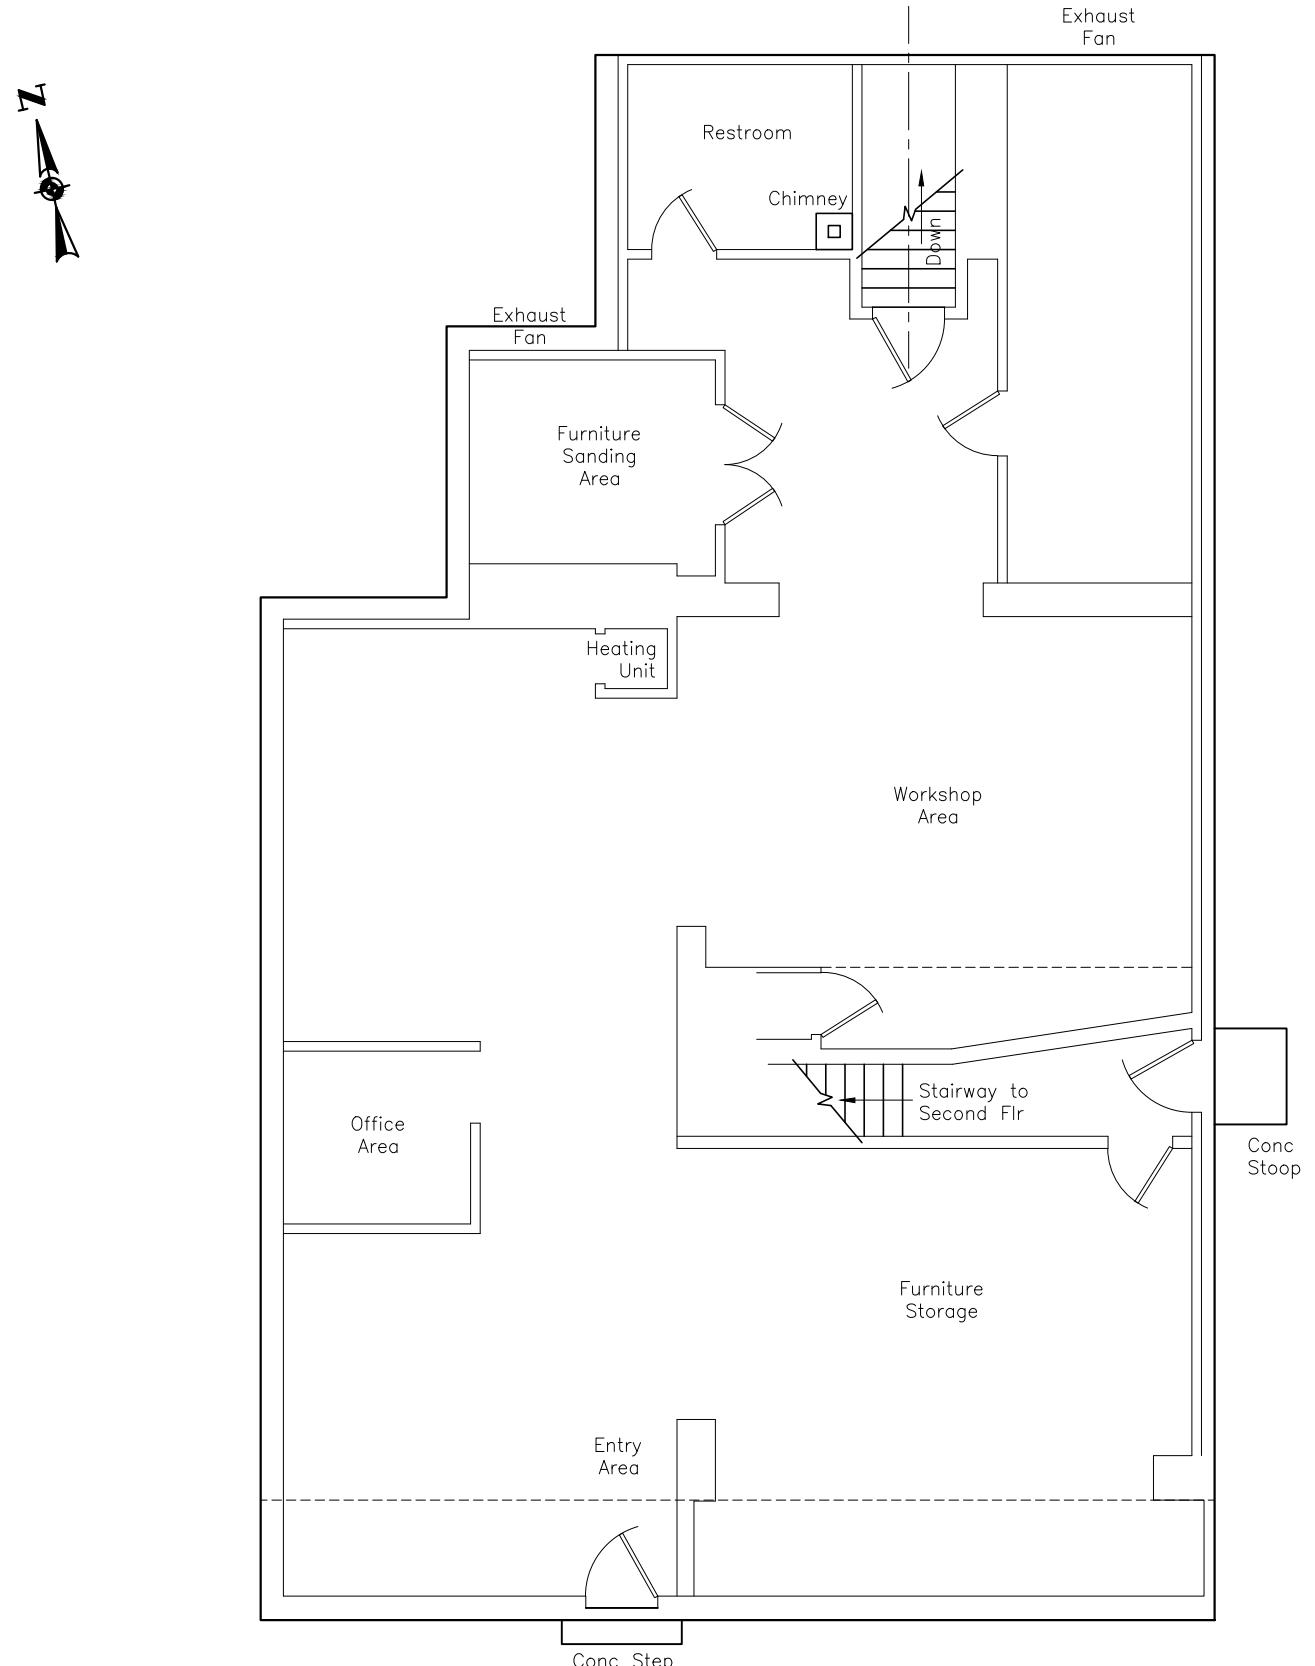

2
SK-2 **FIRST FLOOR PLAN**

LEGEND

● **BASEMENT** Surface Soil Sample Location

□ **Oppb** Surface Soil Location With Maximum PPBRae Photoionization Detector (PID) Reading Recorded In Parts Per Billion (ppb)

▲ **SV-3** Sub-Slab Vapor Sample Location Collected On November 21, 2022

PROJECT TITLE	Monroe County Department of Environmental Services 50 West Main Street, Suite 7100 Rochester, NY 14614 600 Ridge Road Webster Phase II E&A
DRAWING TITLE	Basement and First Floor Plan With Test Locations
PROJECT No.	22-3624S
DWG No.	3b
Sheet	2 of 3
DRAWN BY	Twm/RJM
APPROVED BY	HMM
FIELD VERIFIED BY	HMM
CHECKED BY	HMM
SCALE	1/8"
DATE ISSUED	12-15-2022
DAY ENGINEERING, P.C.	ENVIRONMENTAL ENGINEERING CONSULTANTS ROCHESTER, NEW YORK 14606 NEW YORK, NEW YORK 10170

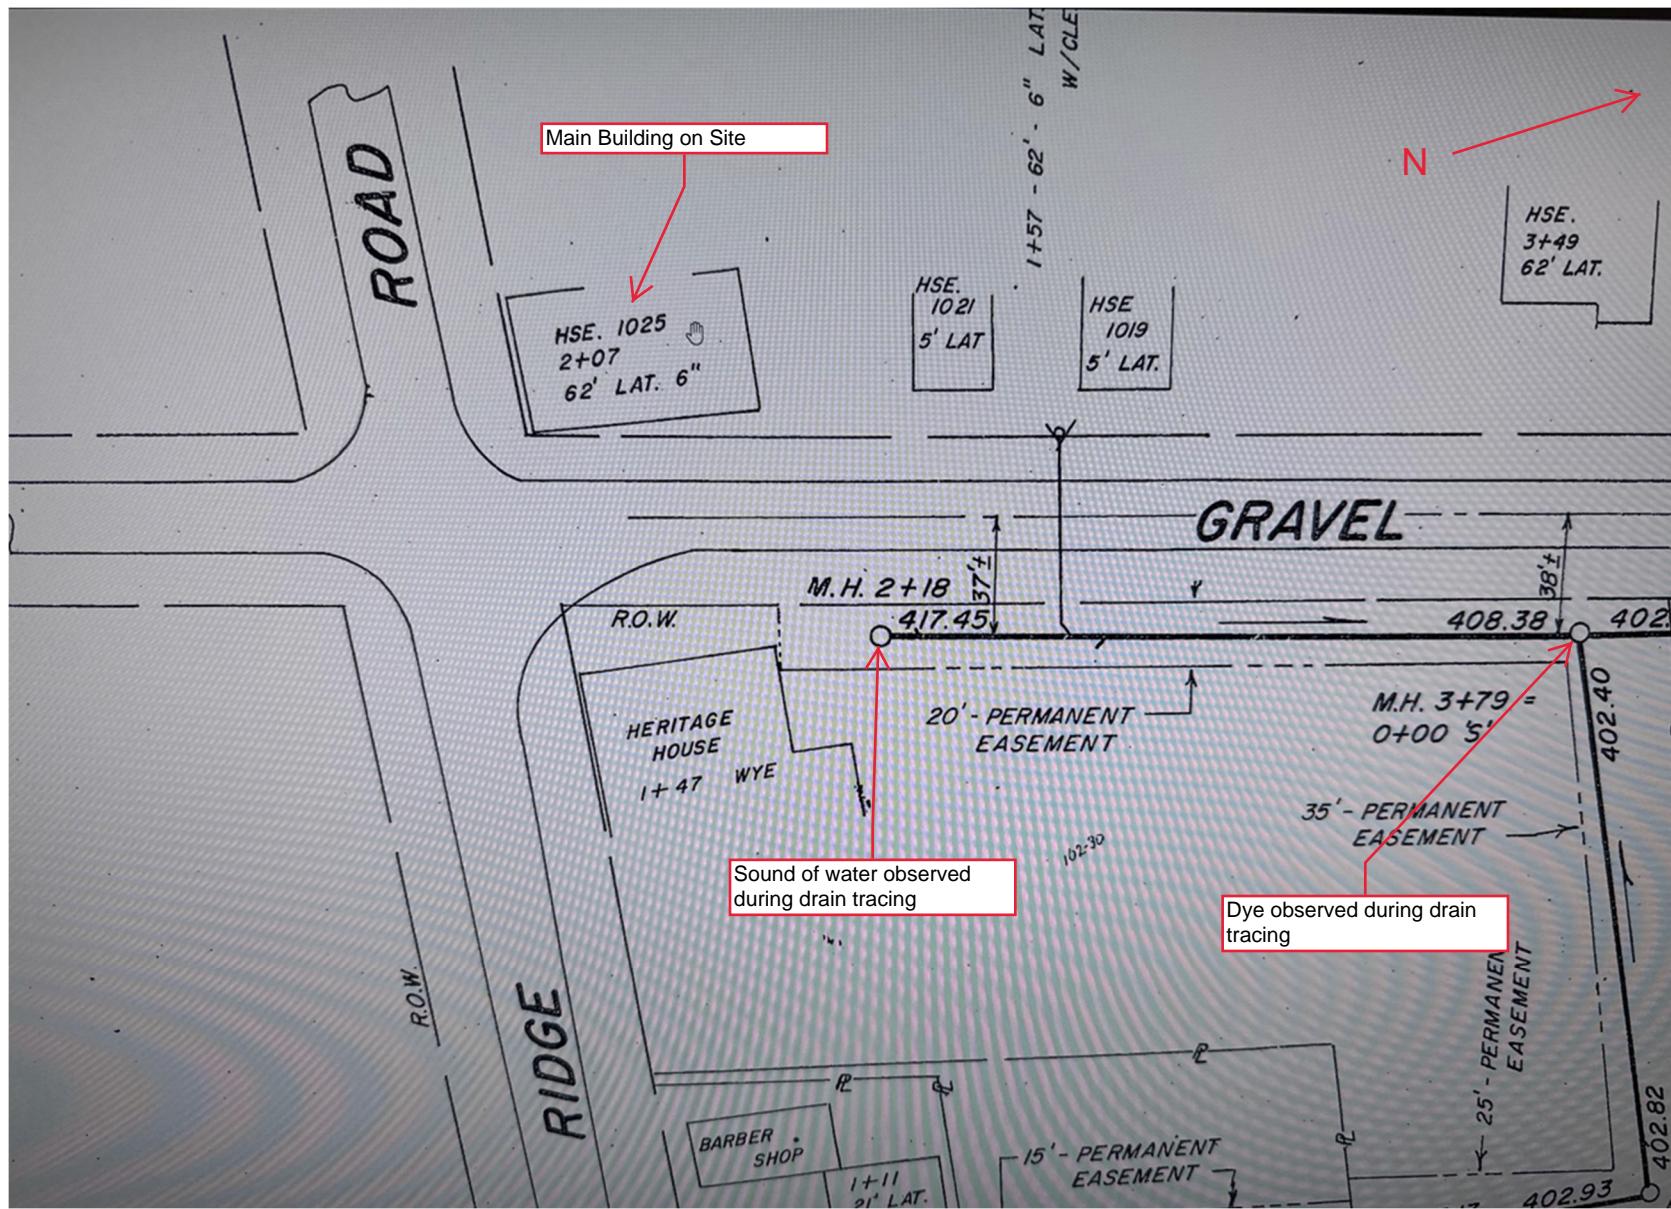


Figure 4: Sewer Map provided by Town of Webster

Note: Sewer map provided
by Jim Montgomery of Town
of Webster, 11/16/2022