


Flush Mounted Front Lit Channel Letter Sign

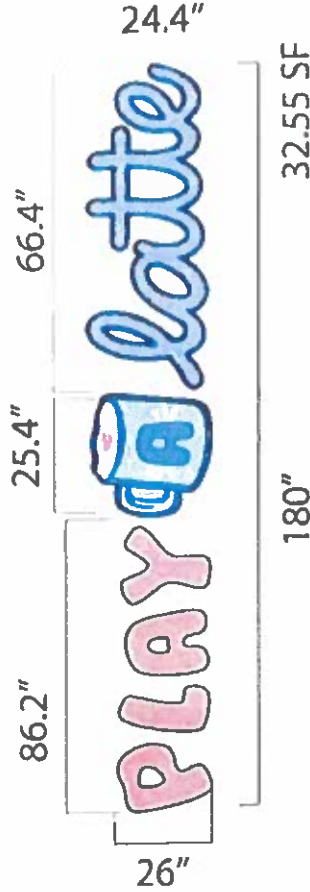

- Channel Letter Depth: 6"
- Black Returns & Trimcap
- Installation Method: Flush Mounted
- Internally Lit With LED's

5.2.2025/COR ML
APPROVED AS NOTED
1. APPROVED by landlord subject to municipal approval and required permits (Town of Webster application)
2. At the end of term, Tenant is to Repair the facade Material (EIFS /Brick etc.) back to its pre-existing condition prior to the installation of the new sign. Tenant may not caulk and paint the previous sign penetrations.
3. Provide rear-service door signage to include: (4"high) Suite # and (2" high) Tenant name in white Vinyl

Please sign & return drawings to FASTSIGNS
Signature below indicates approval of BOTH design & placement of signs
DATE 5/14/25
X

"DRAWING IS NOT TO SCALE BUT IS PROPORTIONATE"
FIELD VERIFY ALL MEASUREMENTS BEFORE BEGINNING ANY WORK.
INSTALLER TO VERIFY MOUNTING SURFACE PRIOR TO INSTALLATION.

FASTSIGNS Make Your Statement	
PROJECT Play A Latte	DATE 5/14/25
DESIGNER Katie Kasmirer	
DRAWING NUMBER 1 of 1	
REV #1	REV DATE
REVISION NOTES	
REV #1	REV DATE
REVISION NOTES	
REV #1	REV DATE
REVISION NOTES	
NOTES	
THIS DRAWING IS THE PROPERTY OF FASTSIGNS. IT IS TO BE USED FOR THE PROJECT ONLY. IT SHALL NOT BE REPRODUCED, COPIED OR DISPOSED OF DIRECTLY OR INDIRECTLY, NOR USED FOR ANY PURPOSE WITHOUT PERMISSION.	

