


OAKWOOD < 50' WIDE > LANE

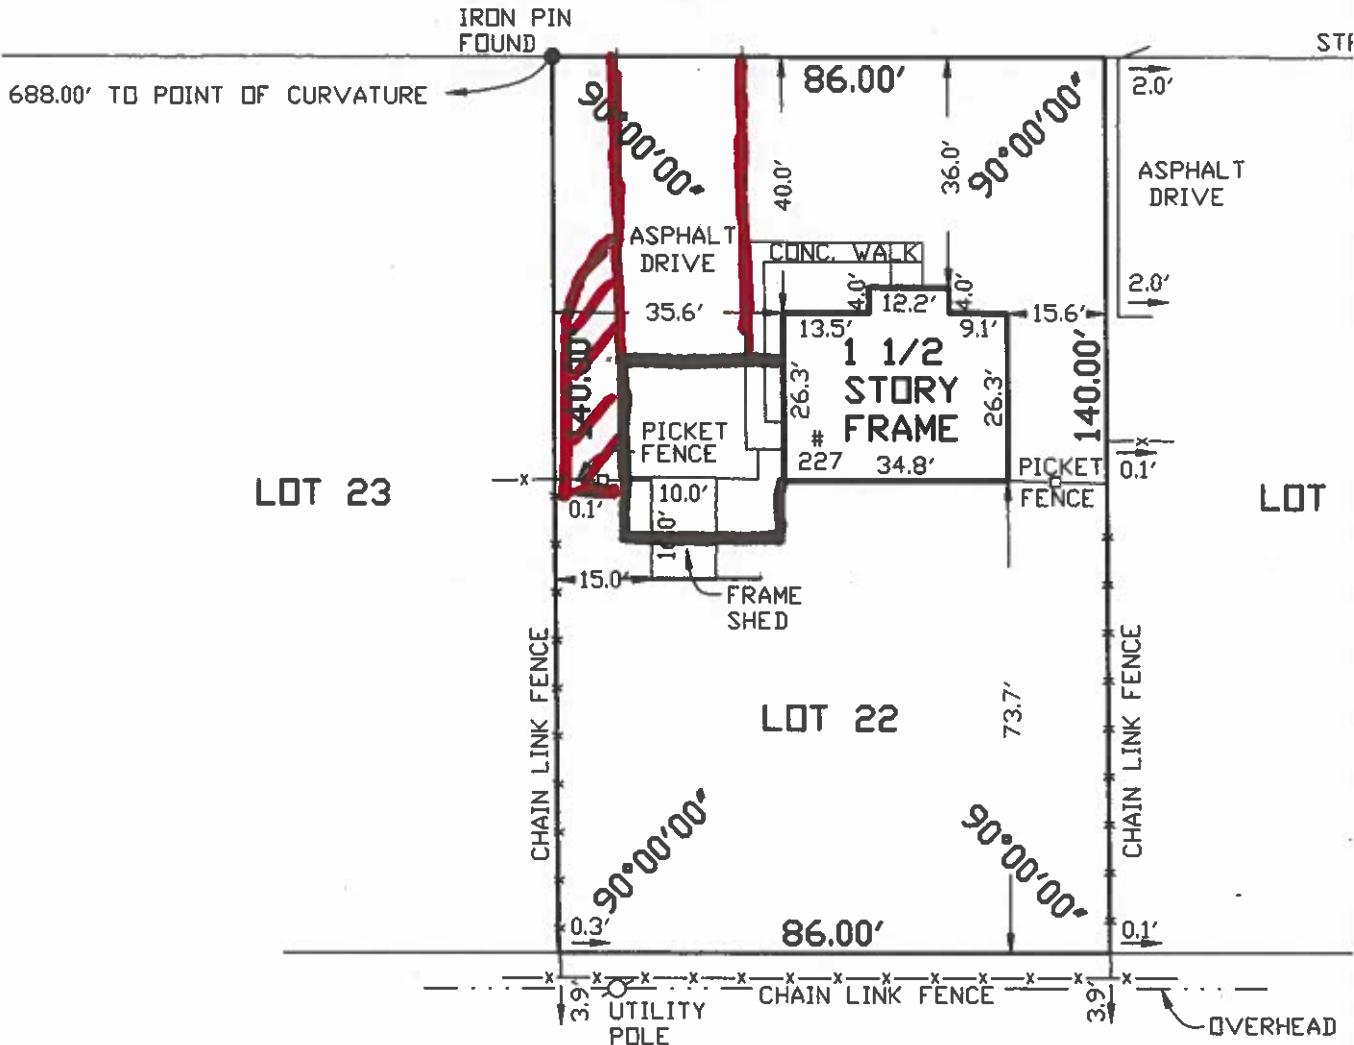

REFERENCES:

- 1) FOUR CORNERS ABSTRACT CORPORATION, ABSTRACT # 132927, DATED JUNE 15, 2000
- 2) LIBER 2829 OF DEEDS, PAGE 311
- 3) LIBER 119 OF MAPS, PAGE 12

NOTES:

- 1) PARCEL SUBJECT TO DECLARATION OF COVENANTS, CONDITIONS, EASEMENTS, AND RESTRICTIONS AS SET FORTH IN LIBER 1000 OF DEEDS, PAGE 1000
- 2) PARCEL SUBJECT TO AN EASEMENT GRANTED TO ROCHESTER GAS AND ELECTRIC CORPORATION AND ROCHESTER TELEPHONE CORPORATION FOR FIXTURES AS SET FORTH IN LIBER 2803 OF DEEDS, PAGE 35
- 3) REFERENCE IS MADE TO AN EASEMENT GRANTED TO ROCHESTER GAS AND ELECTRIC CORPORATION FOR GAS MAINS THROUGH, ALONG, AND ACROSS STREETS PER LIBER 2803 OF DEEDS, PAGE 402

Estimate

WESTERN NY SEALING & PAVING

Paul Schultz

Phone: 585-472-3715

paul.schultz@wnyscalers.com

WNYPAVE.COM

Submitted to: Randy Sprague
Street: 227 Oakwood Ln.
City/State/Zip: Webster NY 14580


Date: 5/1/25
Phone: 585-694-4432
E-mail: randy.sprague@xerox.com
Job Name: DOP / Box / Pave over stone

Description	Total ft. ²
Resurface (Topcoat)	
Asphalt Replacement	1259 sf.
Box Out (paving a new area)	172 sf.
Asphalt Repairs	
Paving Over Existing Stone	314 sf.
Concrete	
Sealing	
Epoxy	
Demolition	

Diagram Notes & Approval

Agent initial

Customer initial

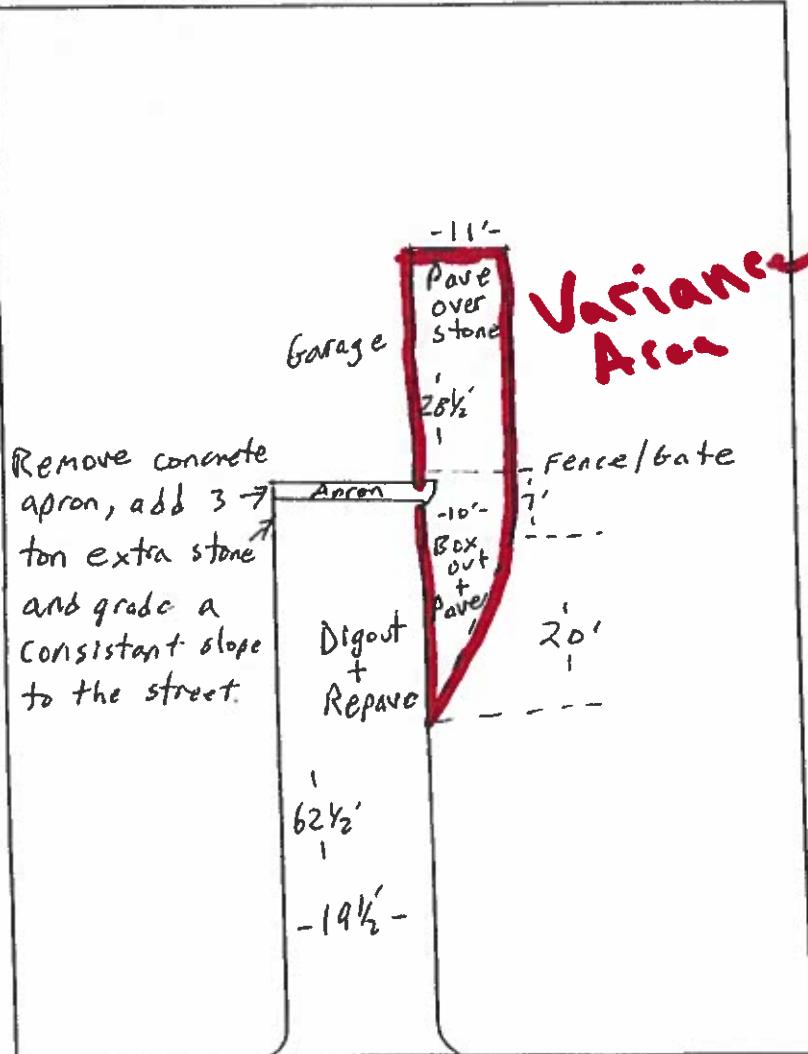

Notes:

Concrete job first!

\$ 5,677

A000149 005137 69185 0000000000 202505191930

Our house at 227 Oakwood Lane Webster is in drastic need of a new driveway to match the new garage that was built. We have been planning the driveway for over a year. We are hoping to be able to add an extension to the driveway and black top up to 1 foot from the west property line and between the garage and fence to improve the curb appeal. Our neighbors told us they don't mind if the driveway was near the property line seeing how we're still unable to get some grass to grow in front of the fence gate on the west side of the property. Below are photos of where we plan to have the driveway extension if you grant us the requested variance.



Thank you for this opportunity.

Randy & Mary Sprague